



出来形平面図

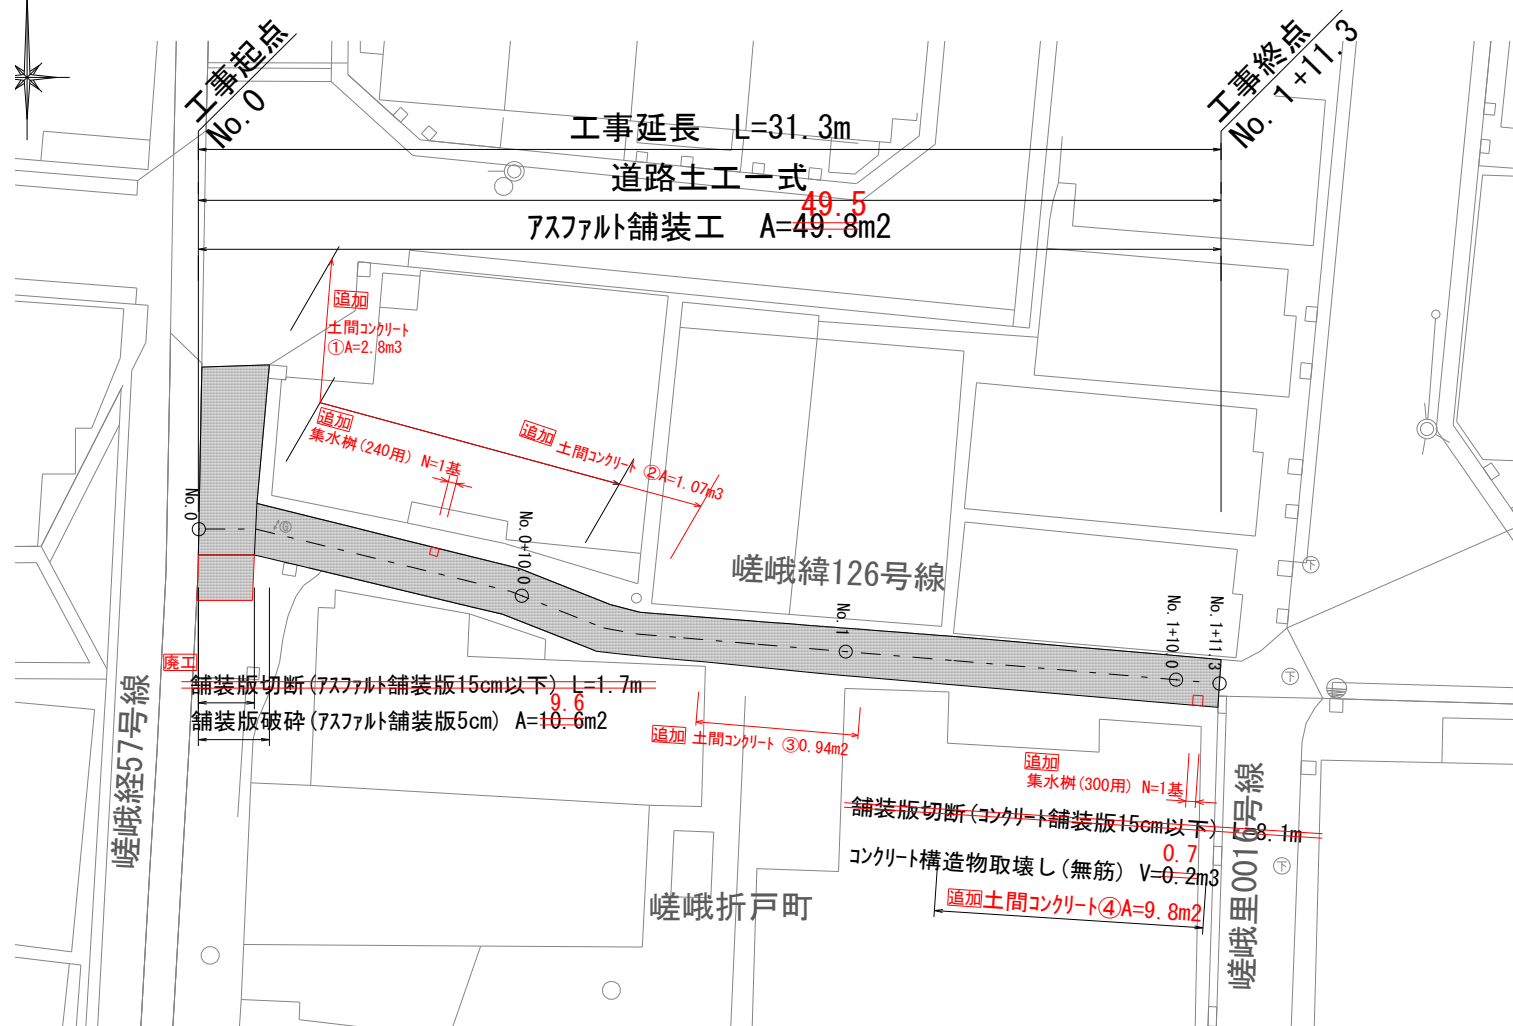

舖裝工 面積

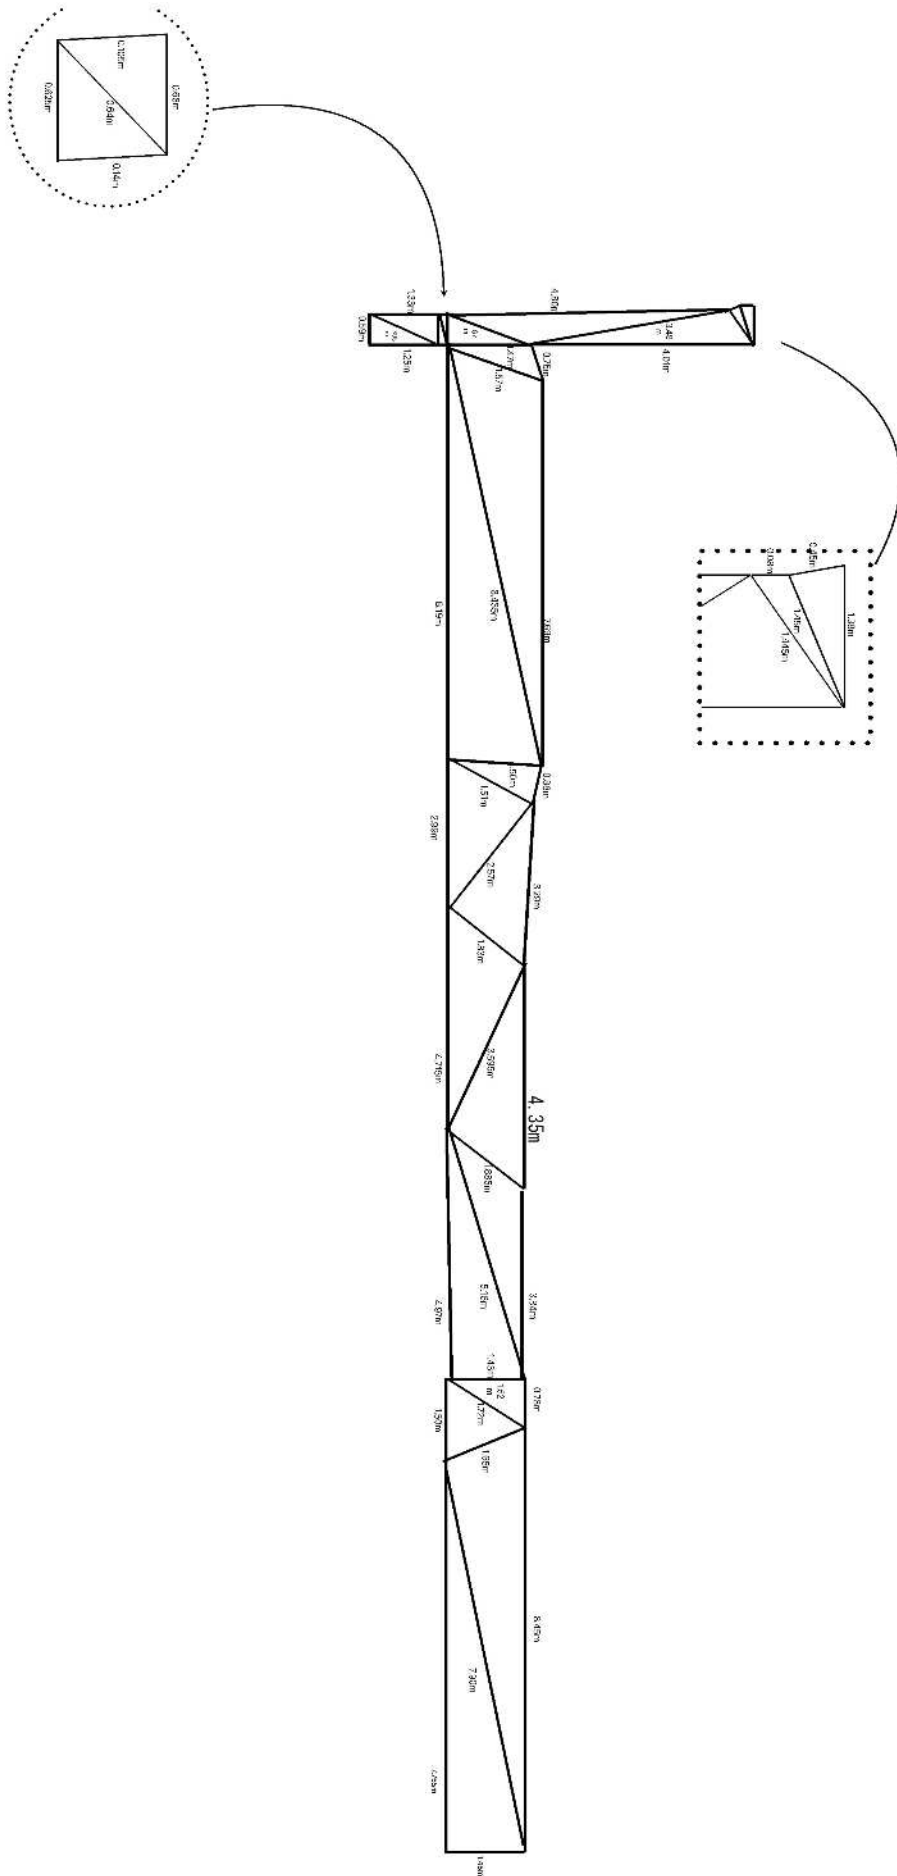


舗装工 面積

アスファルト舗装

	ヘロン公式による面積計算				
	A (m)	B (m)	C (m)	S	面積 (m ²)
①	1.380	0.450	1.450	1.640	0.31
②	1.450	0.080	1.445	1.488	0.05
③	1.445	4.010	3.480	4.468	2.47
④	3.480	4.800	1.670	4.975	2.07
⑤	1.670	1.470	0.680	1.910	0.49
⑥	0.680	0.105	0.640	0.713	0.03
⑦	0.640	0.140	0.625	0.703	0.04
⑧	0.625	1.330	1.395	1.675	0.41
⑨	1.395	1.250	0.590	1.618	0.36
⑩	1.470	0.750	1.570	1.895	0.54
⑪	1.570	7.690	8.435	8.848	5.54
⑫	8.435	8.190	1.500	9.063	6.13
⑬	1.500	0.880	1.510	1.945	0.63
⑭	1.510	2.990	2.570	3.535	1.94
⑮	2.570	3.290	1.830	3.845	2.34
⑯	1.830	4.715	3.595	5.070	2.93
⑰	3.595	4.350	1.885	4.915	3.33
⑱	1.885	3.840	5.160	5.443	2.96
⑲	5.160	4.970	1.430	5.780	3.55
⑳	1.520	0.780	1.720	2.010	0.59
㉑	1.720	1.500	1.650	2.435	1.13
㉒	1.650	8.450	7.900	9.000	6.32
㉓	7.900	7.755	1.450	8.553	5.62
合計					49.78
合計ー集水枳平米(m2)					49.50
舗装工面積					49.50

土間コンクリート 面積

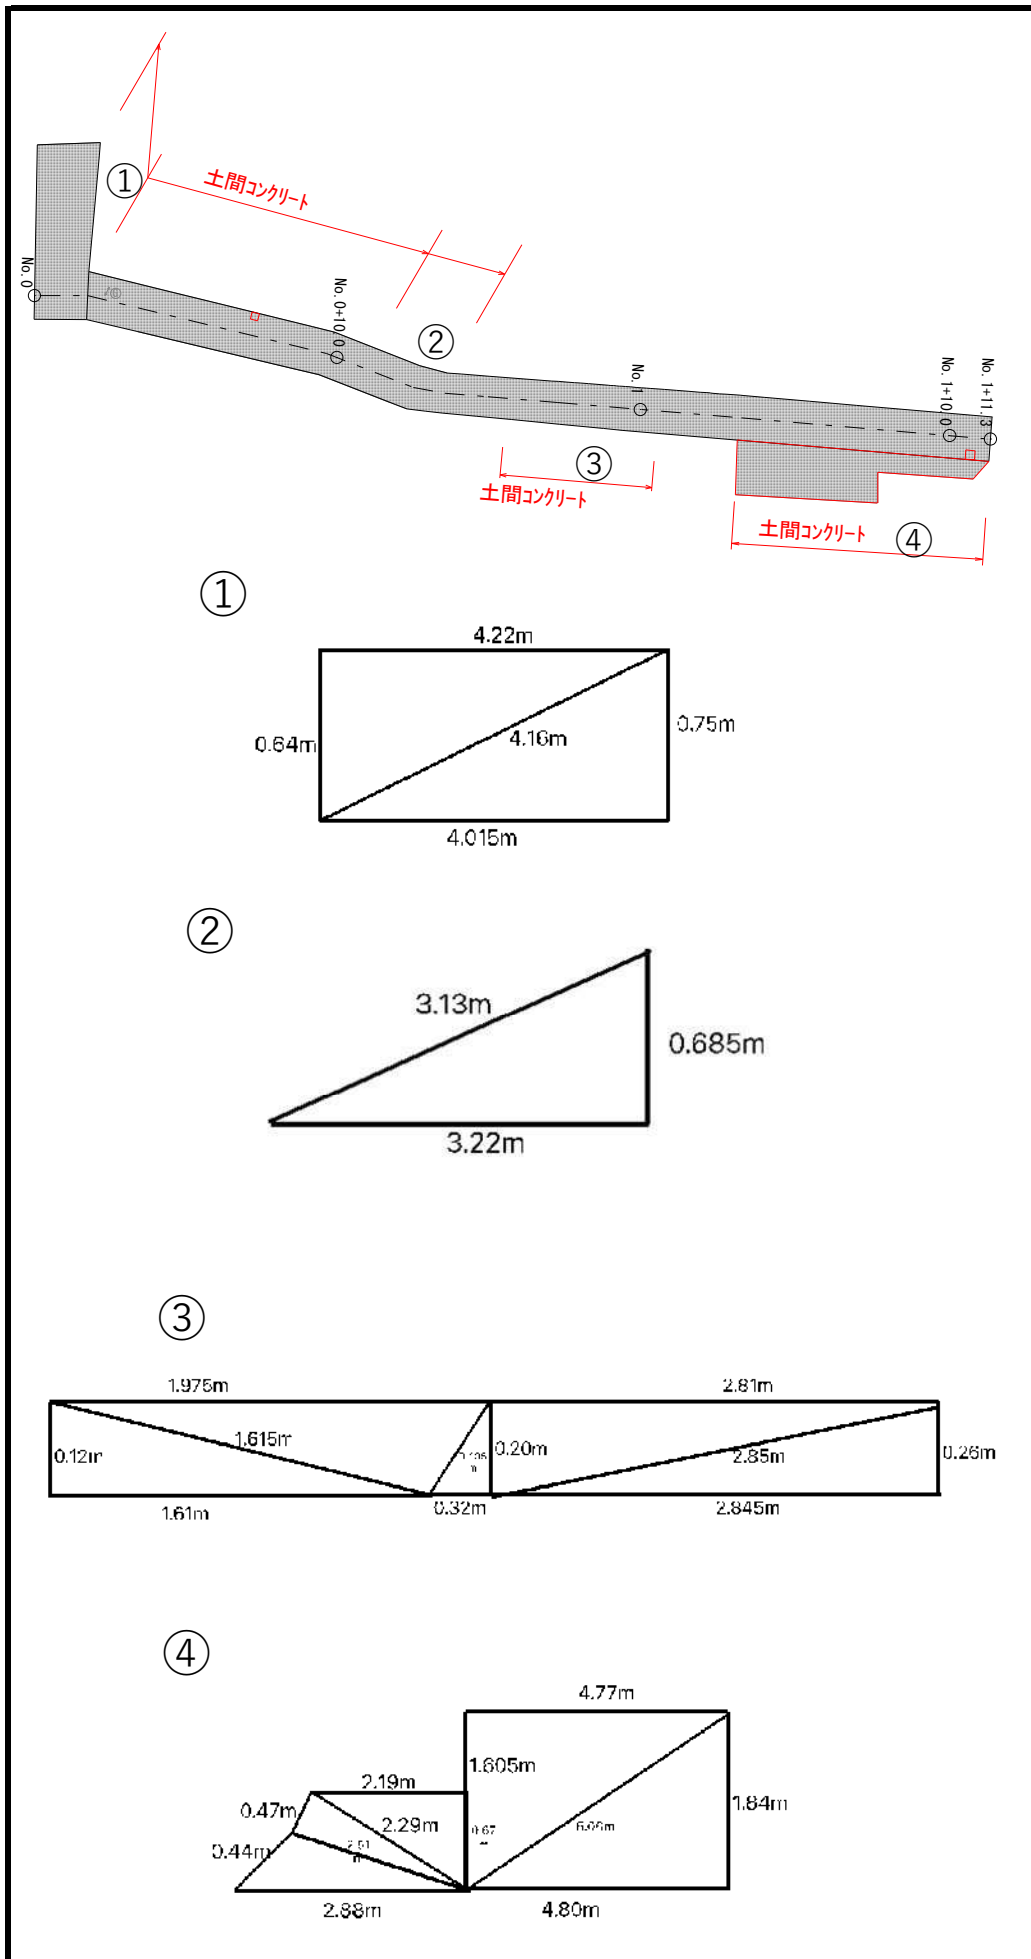

ヘロン計算表コンクリート

A(M)	B(M)	C(M)		面積 m ²
0.44	2.88	2.51		0.319793
0.47	2.51	2.29		0.496002
2.19	2.29	0.67		0.73365
1.61	4.77	5.06		3.827309
5.06	4.8	1.84		4.411216
				0
0.12	1.61	1.62		0.096599
1.62	1.98	0.41		0.165459
0.41	0.2	0.32		0.03154
0.2	2.81	2.85		0.277109
2.85	2.85	0.26		0.369721
				0
3.13	3.22	0.69		1.07172
				0
0.64	4.22	4.16		1.330996
4.16	4.02	0.75		1.497551
			合計値	14.62866